
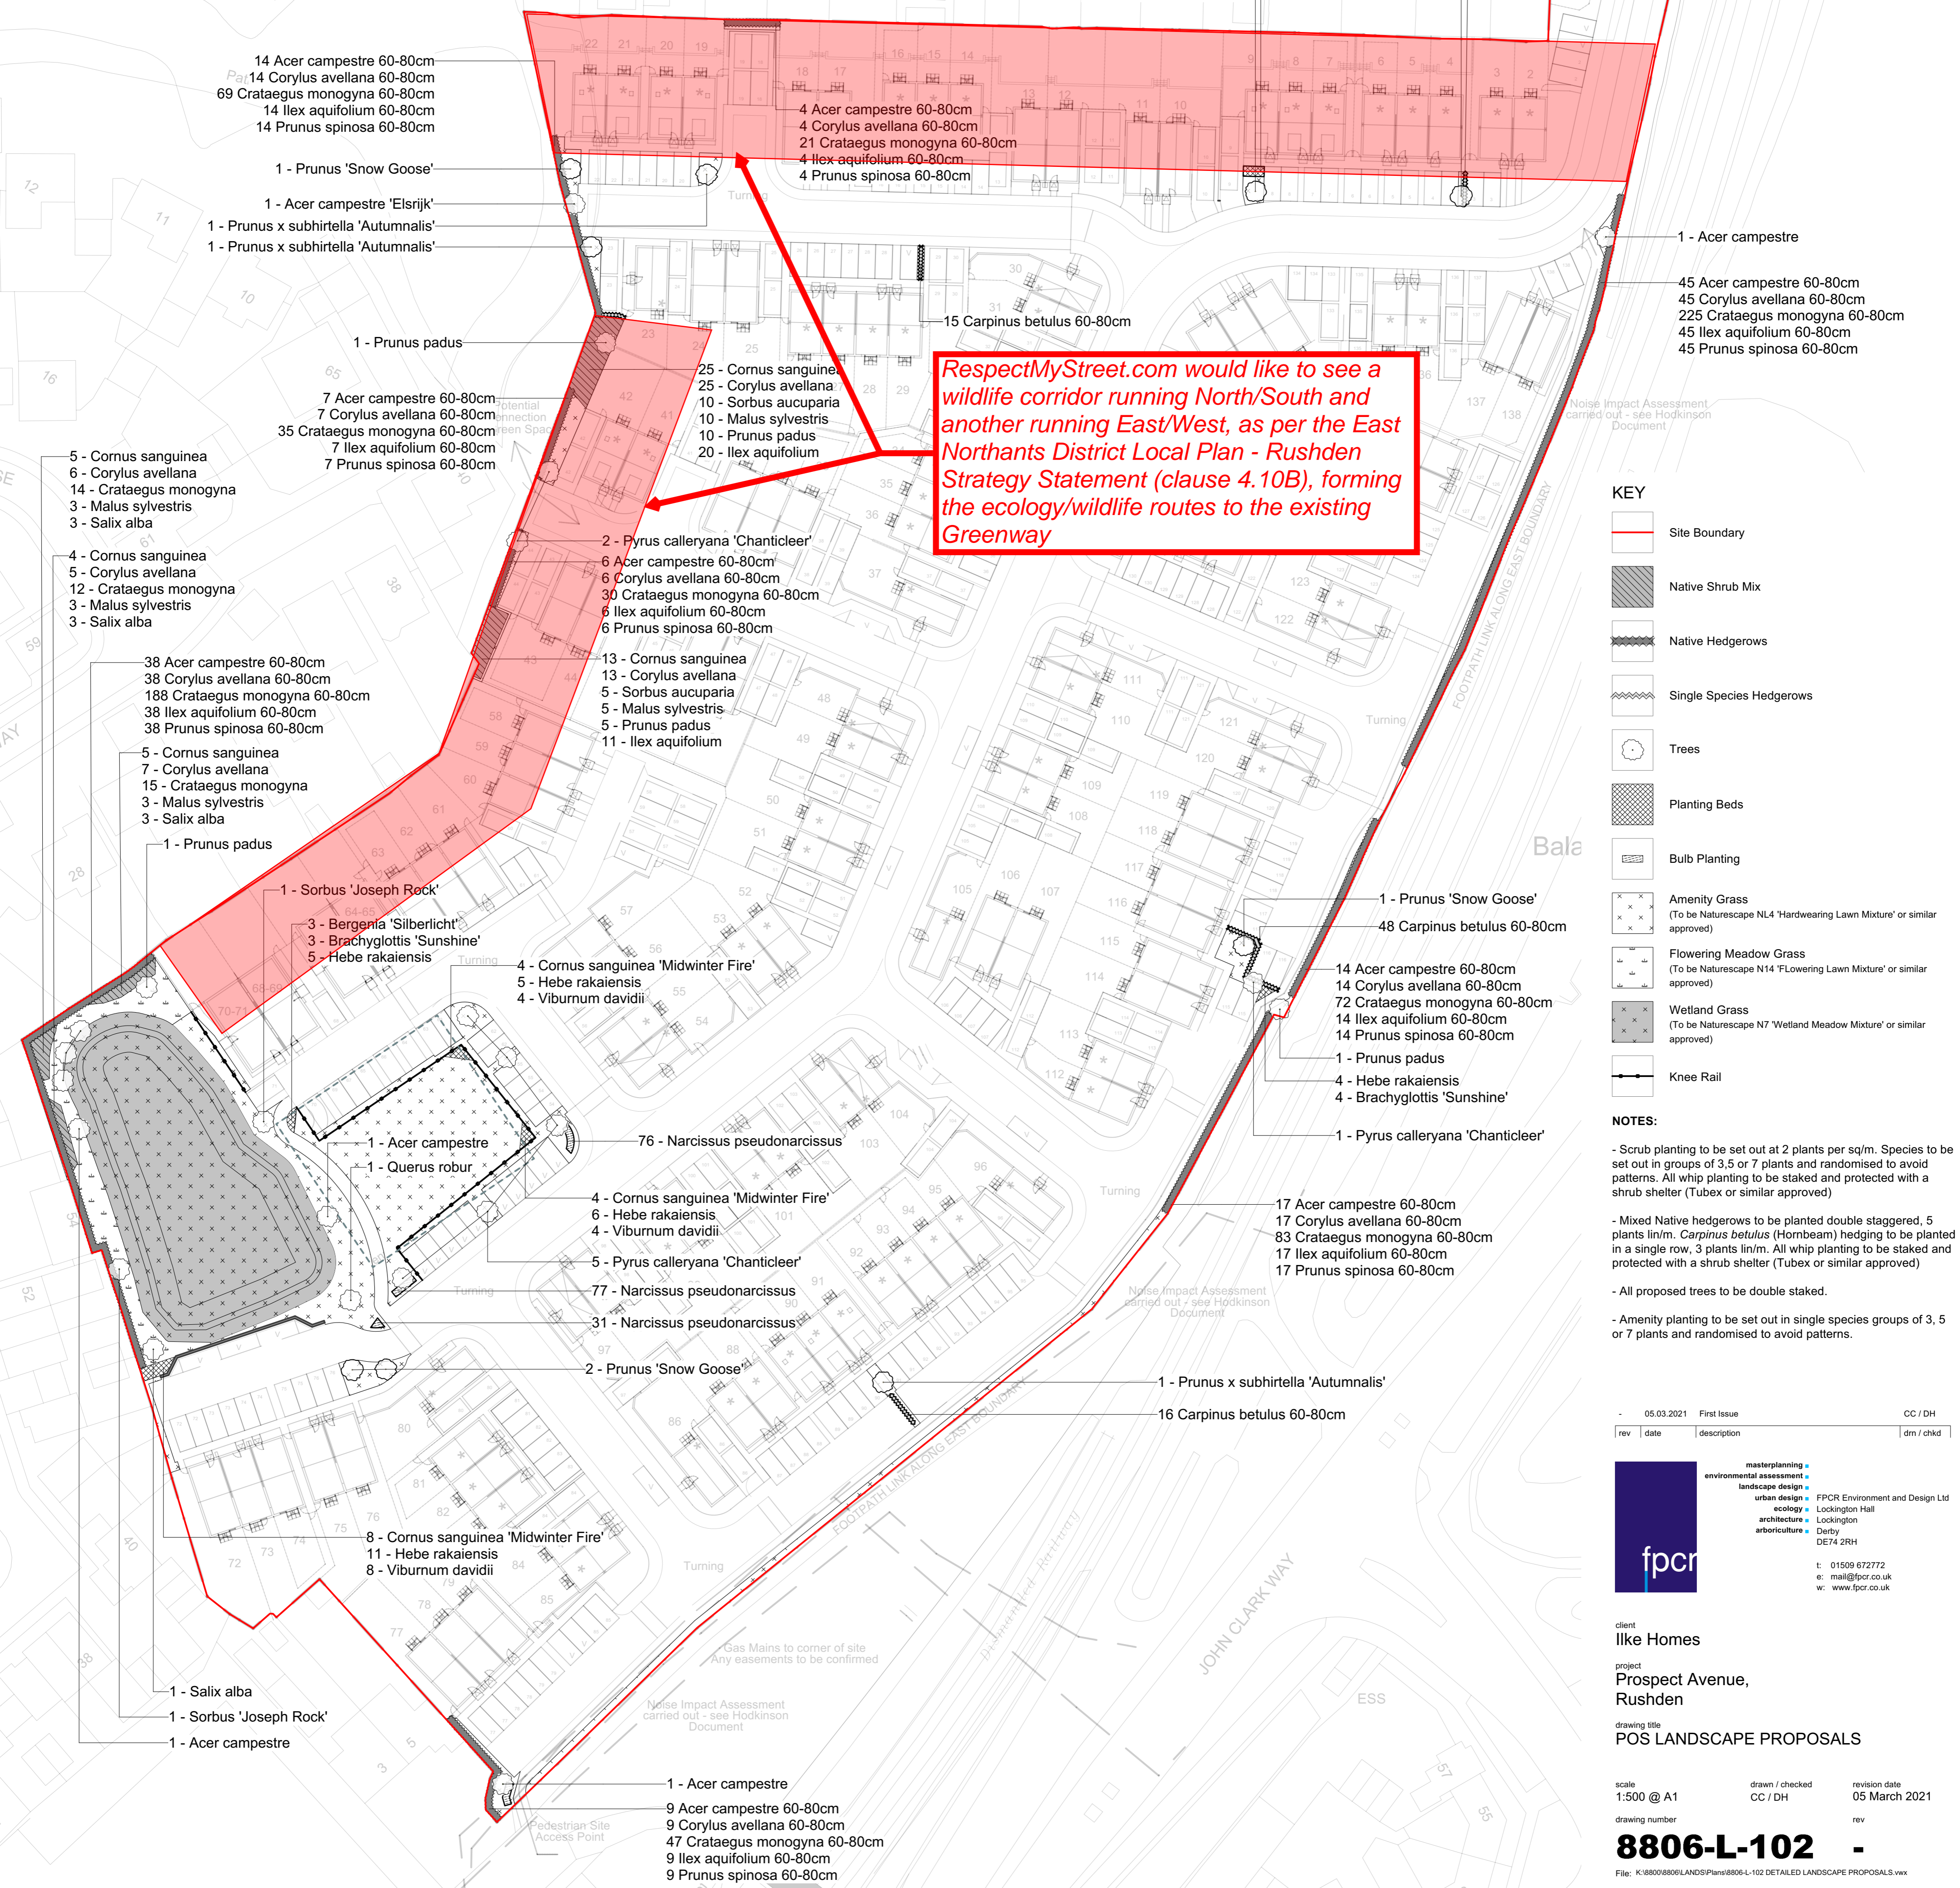


Qty	Latin Name	Common Name	Height	Form	Root Condition	Rate/Spacing	
NATIVE SHRUB PLANTING							
52	Cornus sanguinea	Common dogwood	60-80cm	Whip	BR	2 Plants/sq m	
56	Corylus avellana	Hazel	60-80cm	Whip	BR	2 Plants/sq m	
15	Sorbus aucuparia	Rowan	60-80cm	Whip	BR	2 Plants/sq m	
24	Malus sylvestris	Crab Apple	60-80cm	Whip	BR	2 Plants/sq m	
15	Prunus padus	Bird Cherry	60-80cm	Whip	BR	2 Plants/sq m	
31	Ilex aquifolium	Holly	60-80cm	Whip	BR	2 Plants/sq m	
41	Crataegus monogyna	Common hawthorn	60-80cm	Whip	BR	2 Plants/sq m	
9	Salix alba	White Willow	60-80cm	Whip	BR	2 Plants/sq m	
AMENITY PLANTING							
14	Anemanthele lessoniana	New Zealand Wind Grass	30-40cm	3L		5 Plants/sq m	
28	Bergenia 'Silberlicht'	Elephant's Ears	20-30cm	3L		5 Plants/sq m	
34	Brachyglottis 'Sunshine'	Senecio 'Sunshine'	30-40cm	5L		3 Plants/sq m	
30	Cornus sanguinea 'Midwinter Fire'	Dogwood	40-60cm	5L		3 Plants/sq m	
5	Euonymus fortunei 'Silver Queen'	Wintercreeper	20-30cm	5L		3 Plants/sq m	
64	Hebe rakaiensis	Shrubby Veronica	30-40cm	5L		3 Plants/sq m	
39	Viburnum davidii	David Viburnum	40-60cm	5L		3 Plants/sq m	
TREES							
Qty	Latin Name	Common Name	Height	Form	Root Condition	Minimum Clear Stem	Girth
4	Acer campestre	Field maple	450-500cm	Extra Heavy Standard	RB	Min 200cm	16-18cm
2	Acer campestre 'Elsrijk'	Field maple 'Elsrijk'	450-500cm	Extra Heavy Standard	RB	Min 200cm	16-18cm
3	Prunus padus	Bird Cherry	450-500cm	Extra Heavy Standard	RB	Min 200cm	16-18cm
6	Prunus 'Snow Goose'	Flowering Cherry	400-450cm	Extra Heavy Standard	RB	Min 200cm	14-16cm
6	Prunus x subhirtella 'Autumnalis'	Winter Flowering Cherry	400-450cm	Extra Heavy Standard	RB	Min 200cm	14-16cm
8	Pyrus calleryana 'Chanticleer'	Callery Pear	450-500cm	Extra Heavy Standard	RB	Min 200cm	16-18cm
1	Quercus robur	Oak	450-500cm	Extra Heavy Standard	RB	Min 200cm	16-18cm
4	Salix alba	White Willow	300-350cm	Selected Standard	RB	Min 200cm	10-12cm
2	Sorbus 'Joseph Rock'	Rowan	450-500cm	Extra Heavy Standard	RB	Min 200cm	14-16cm
MIXED NATIVE HEDGEROWS (planted double staggered, 5 plants lin/m)							
Qty	Latin Name	Common Name	Height	Form	Root Condition		
164	Acer campestre	Field Maple	60-80cm	Whip	BR		
164	Corylus avellana	Hazel	60-80cm	Whip	BR		
822	Crataegus monogyna	Common hawthorn	60-80cm	Whip	BR		
164	Ilex aquifolium	Holly	60-80cm	Container	C		
164	Prunus spinosa	Blackthorn	60-80cm	Whip	BR		
SINGLE SPECIES HEDGEROWS (planted in a single row, 3 plants lin/m)							
Qty	Latin Name	Common Name	Height	Form	Root Condition		
157	Carpinus betulus	Hornbeam	60-80cm	Whip	BR		
BULB PLANTING							
Qty	Latin Name	Common Name	Rate/Spacing				
390	Narcissus pseudonarcissus	Daffodil	20 Plants/sq m				

NOTES
 This drawing is the property of FPCR Environment and Design Ltd and is issued on the condition it is not reproduced, retained or disclosed to any unauthorised person, either wholly or in part without written consent of FPCR Environment and Design Ltd.
 Ordnance Survey base mapping - supplied by client.

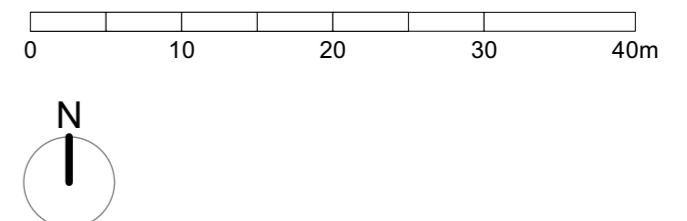

rev	date	description	dm / chkd
	05.03.2021	First Issue	CC / DH

client: Ilke Homes
 project: Prospect Avenue, Rushden
 drawing title: POS LANDSCAPE PROPOSALS

scale: 1:500 @ A1
 drawn / checked: CC / DH
 revision date: 05 March 2021

drawing number: 8806-L-102

File: K:\8806\8806LANDSCAPE\8806-L-102 DETAILED LANDSCAPE PROPOSALS.vxd